




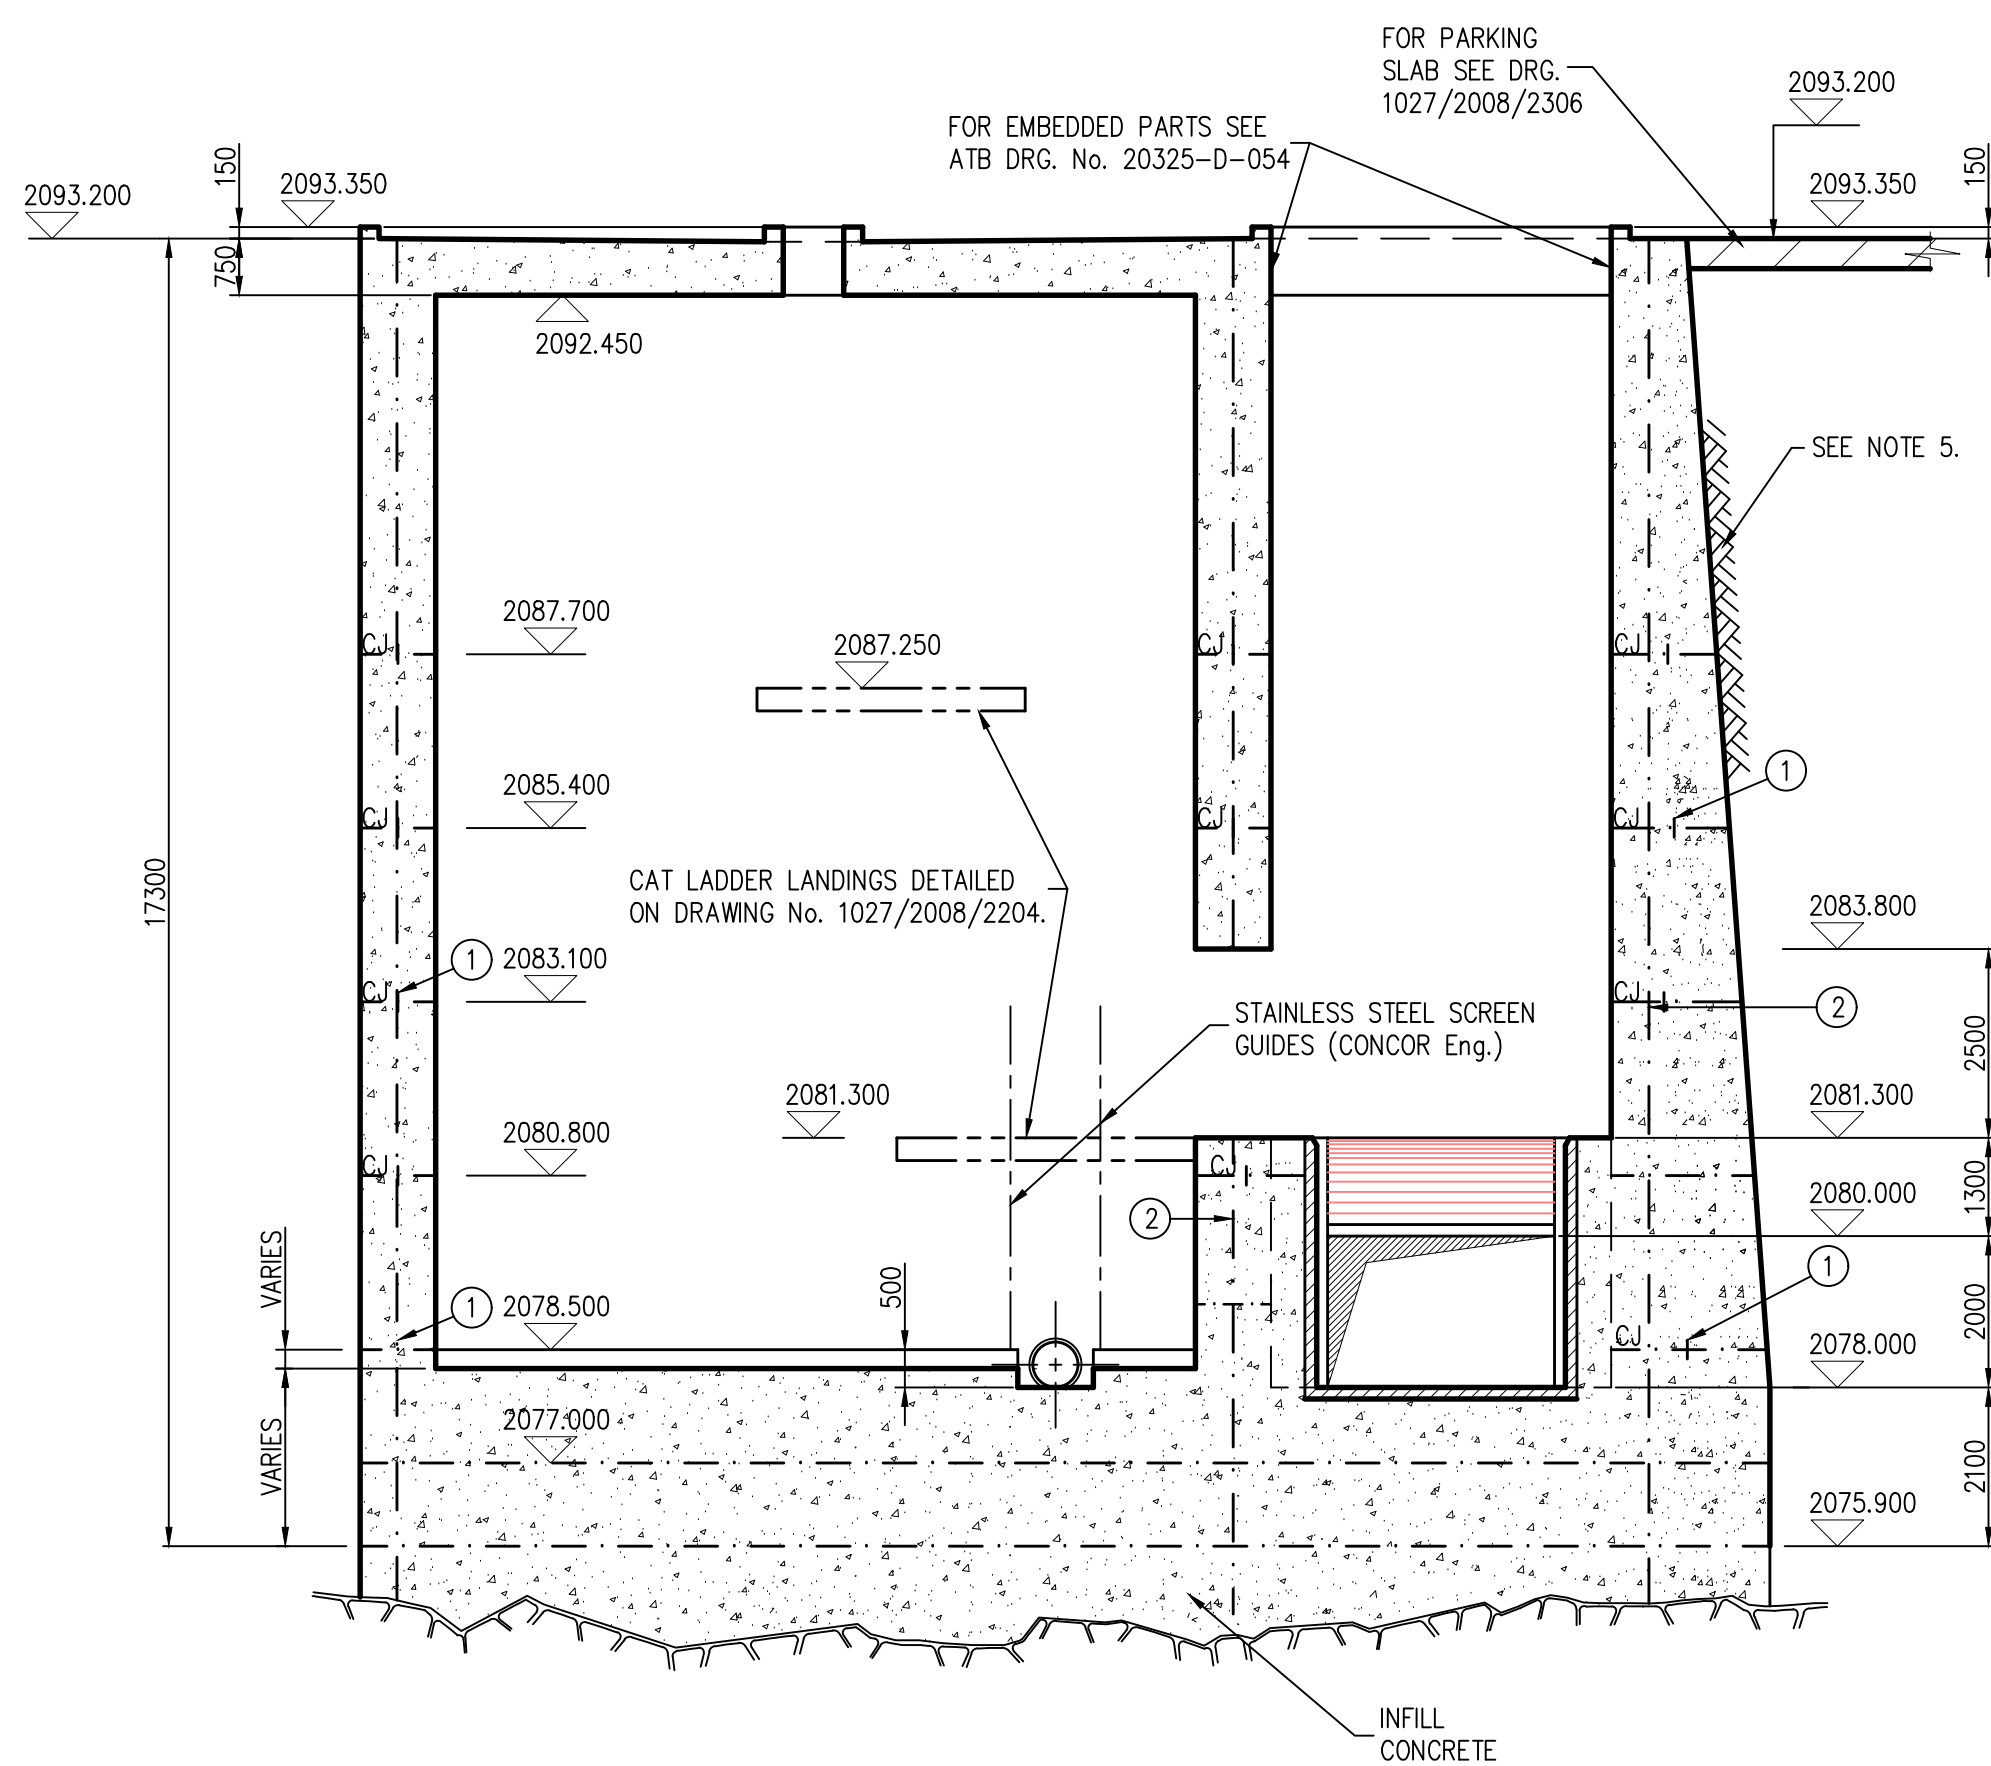


SECTION J
1:100

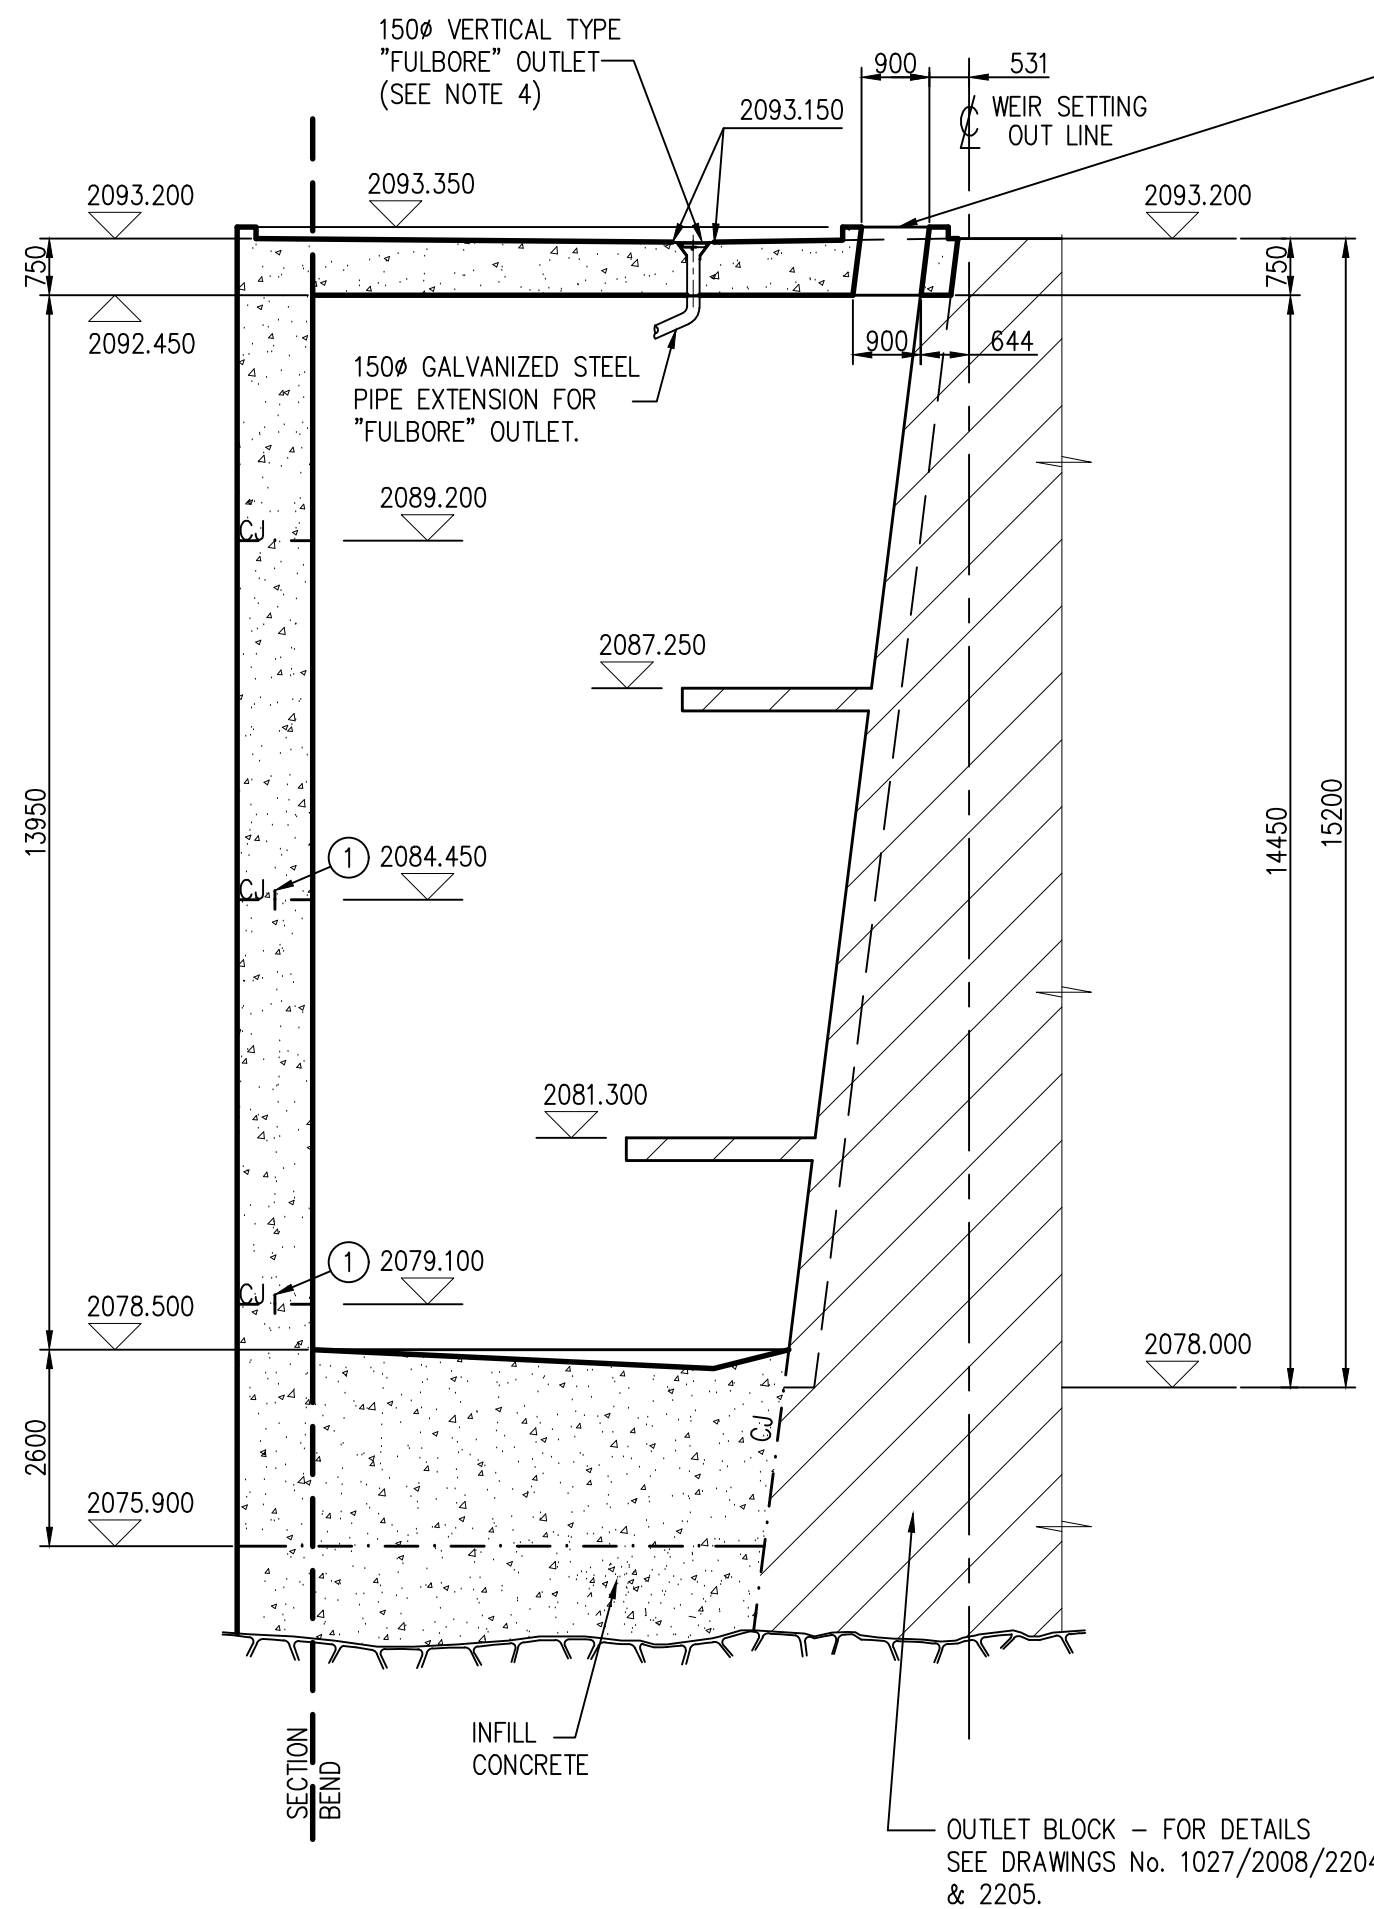


SECTION K
1:100

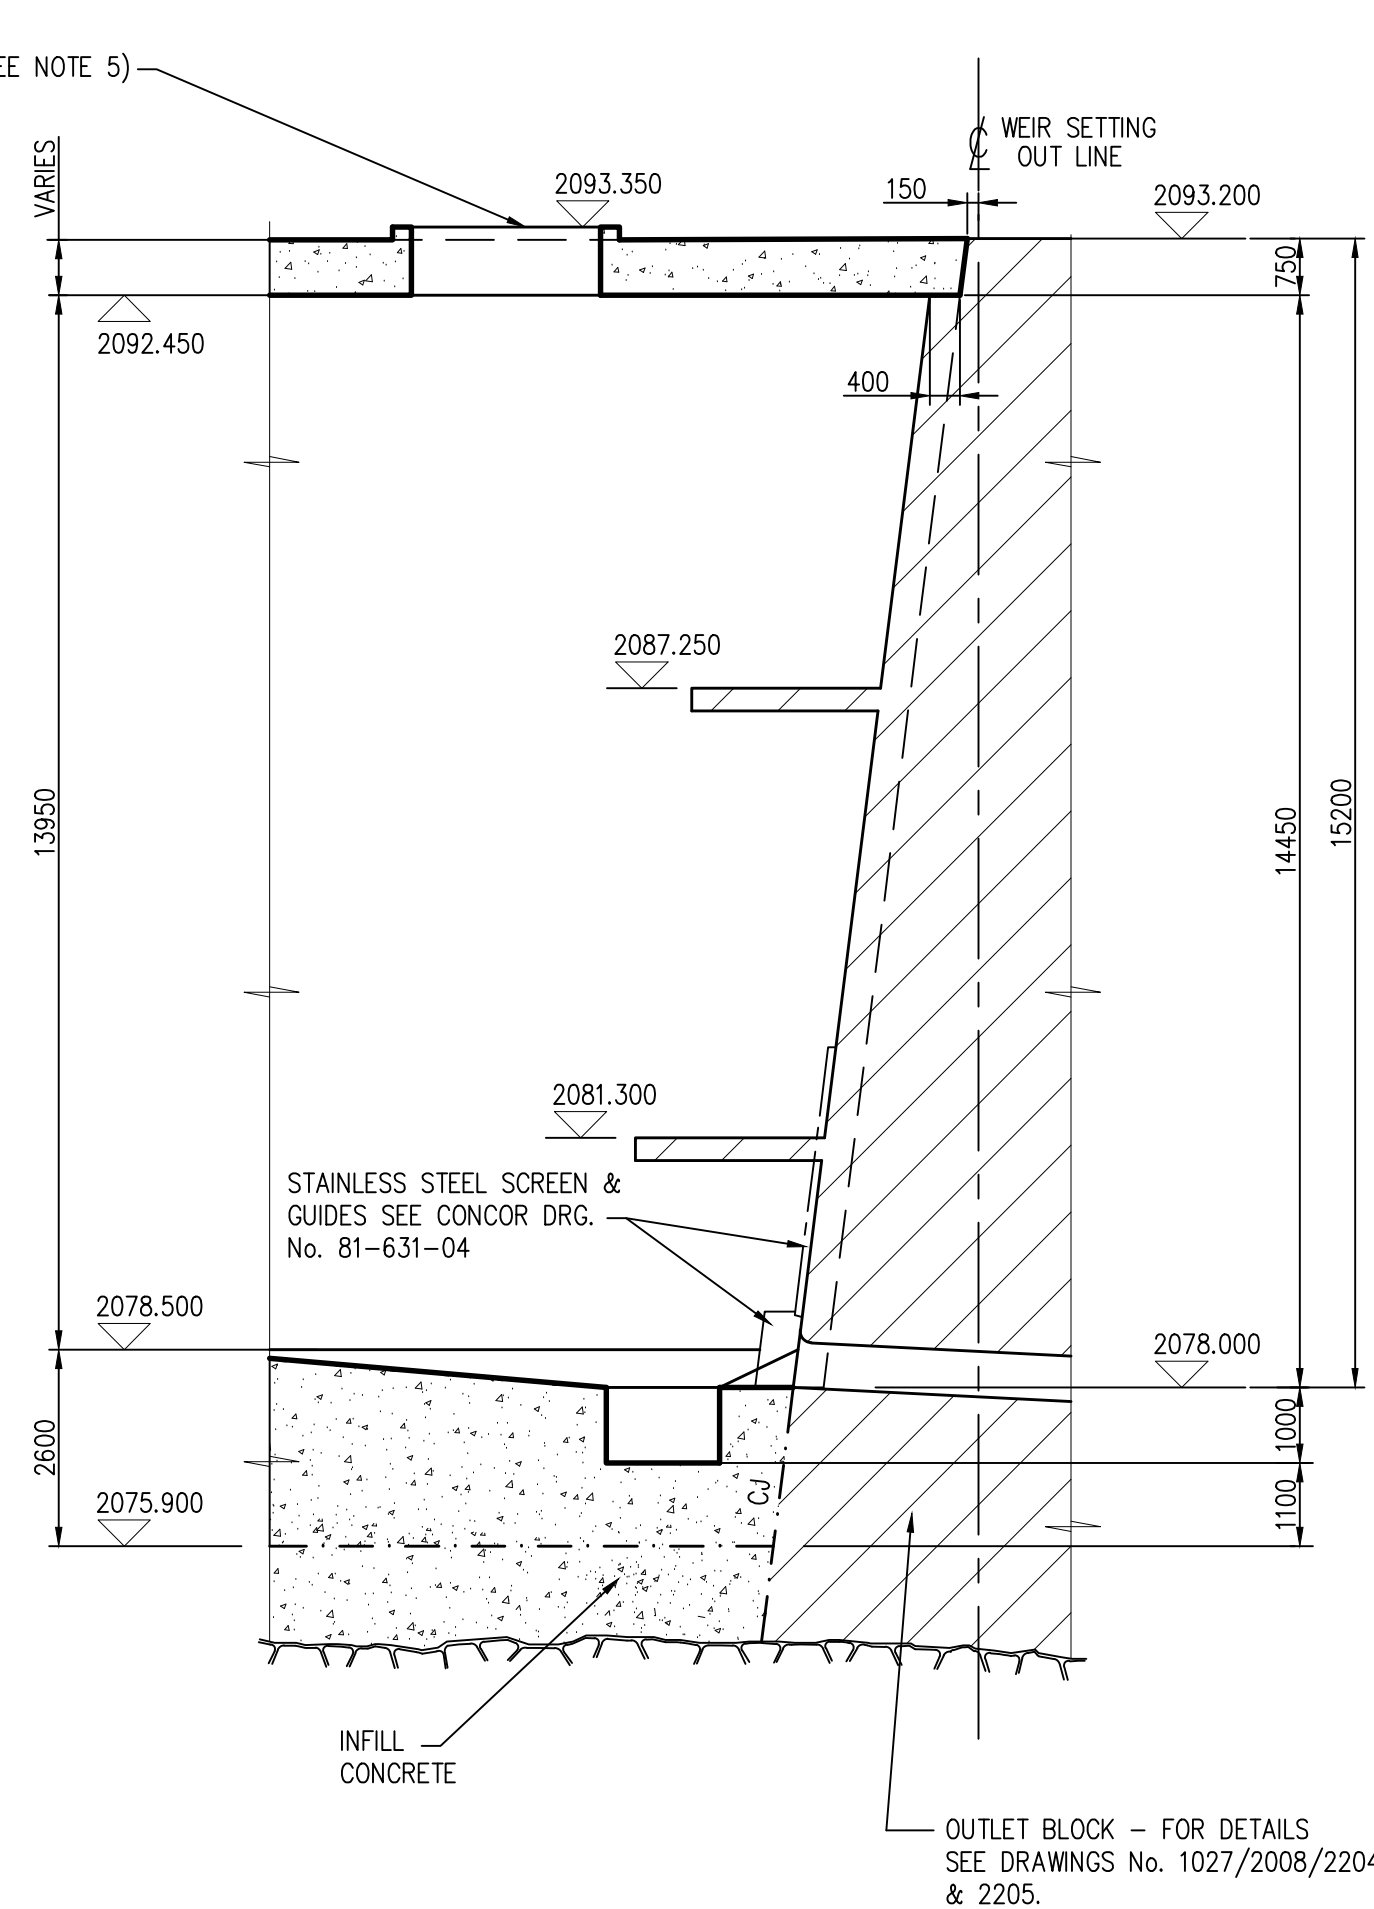


SECTION L
1:100

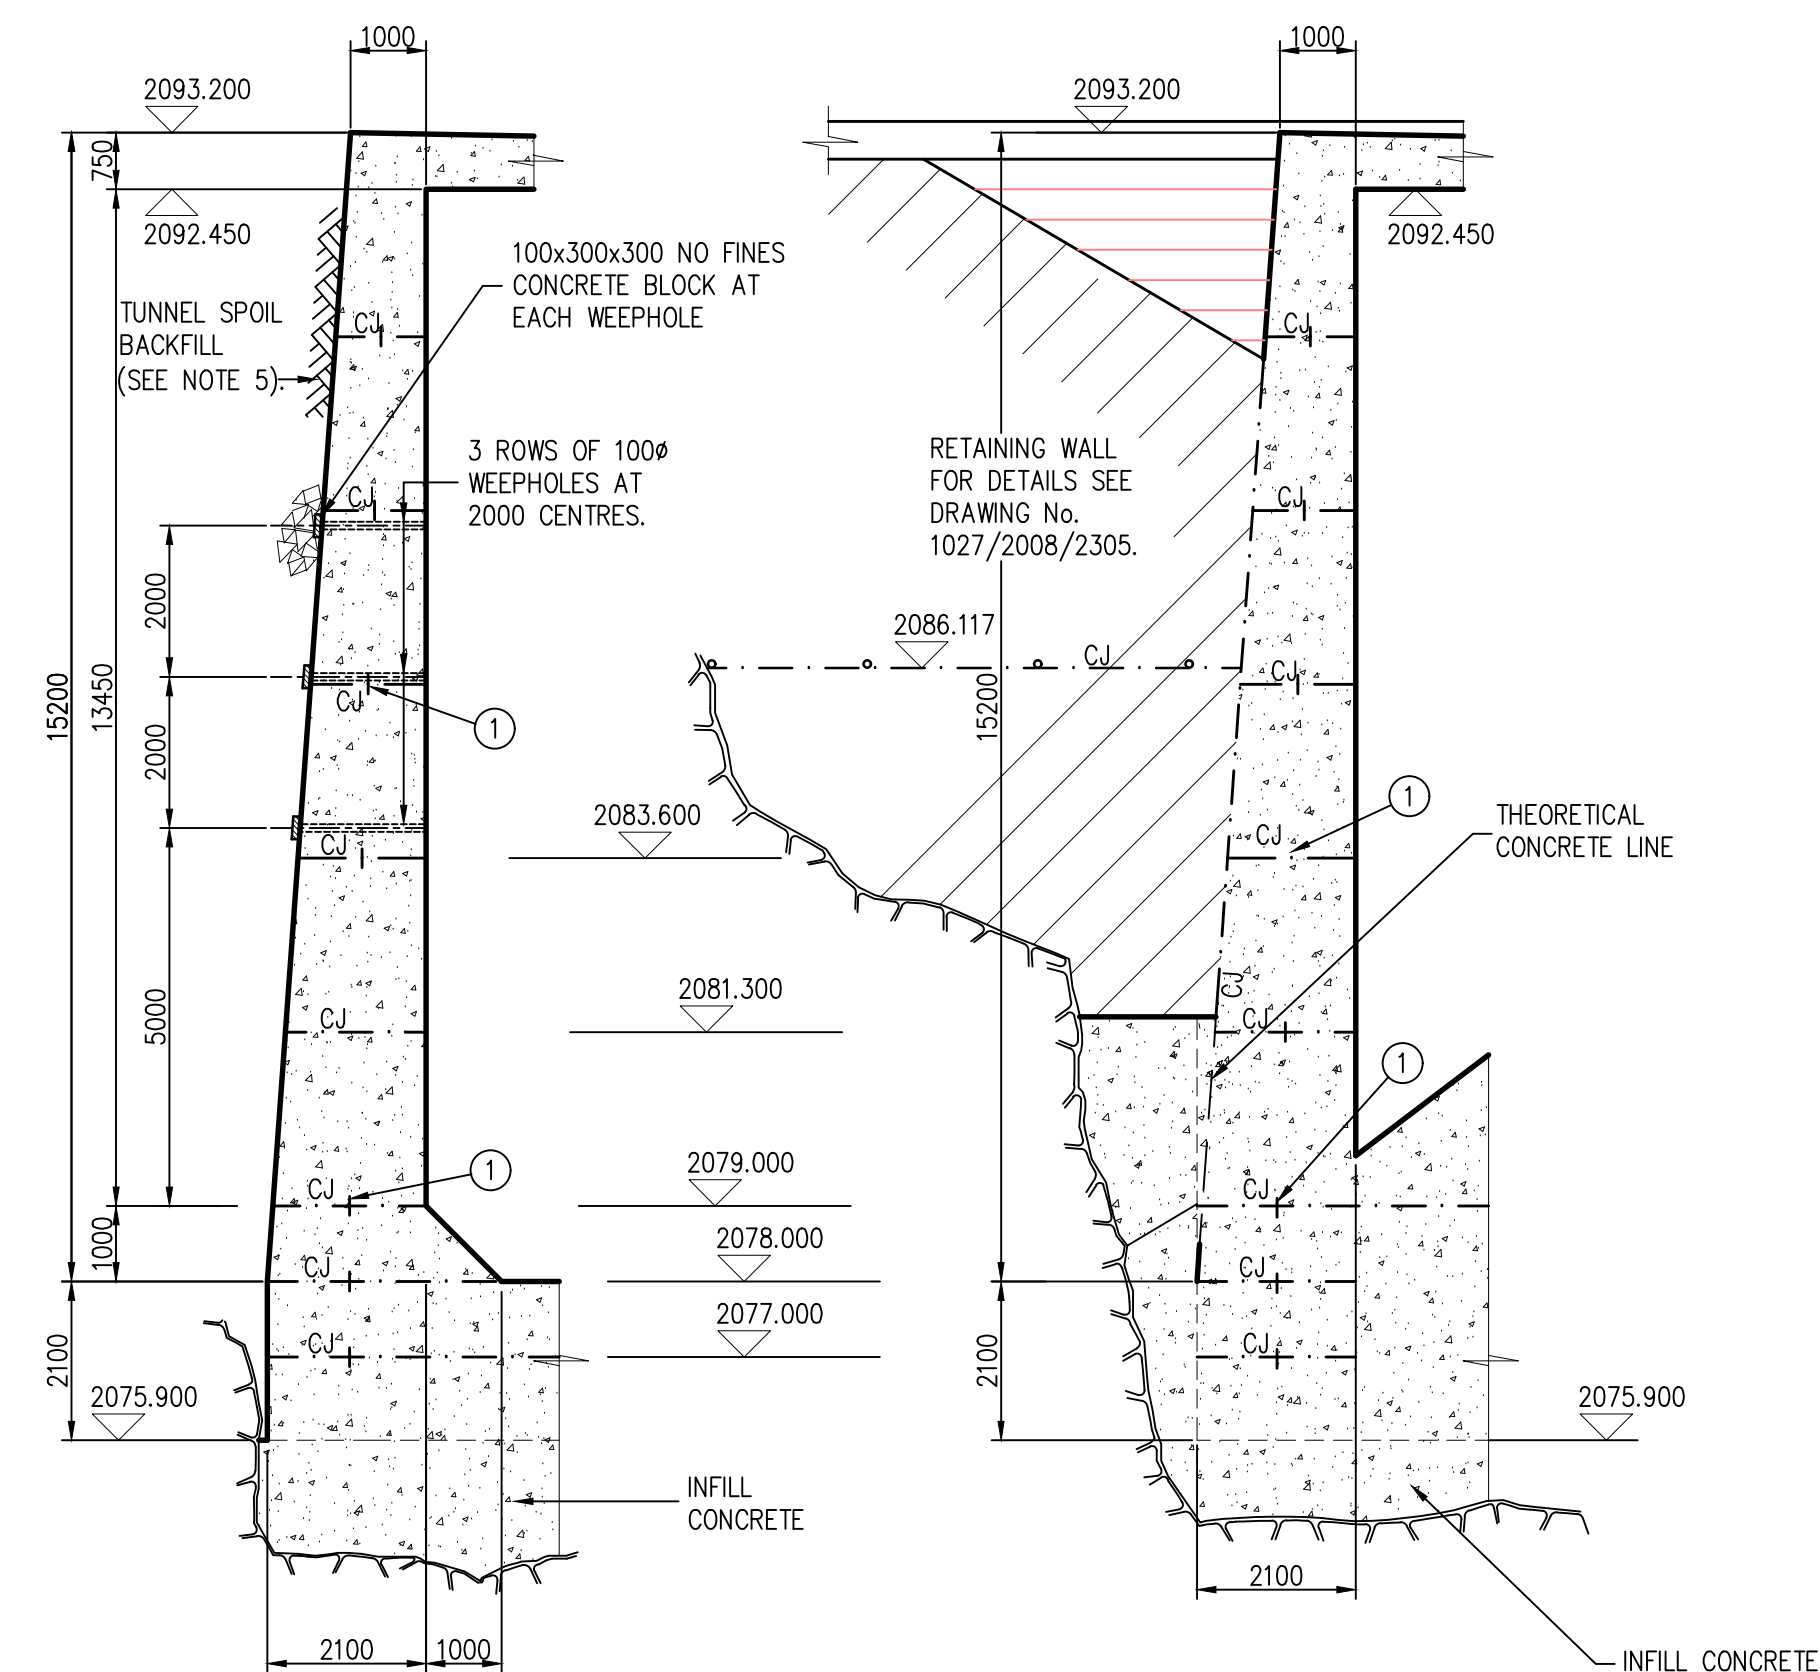


SECTION M
1:100

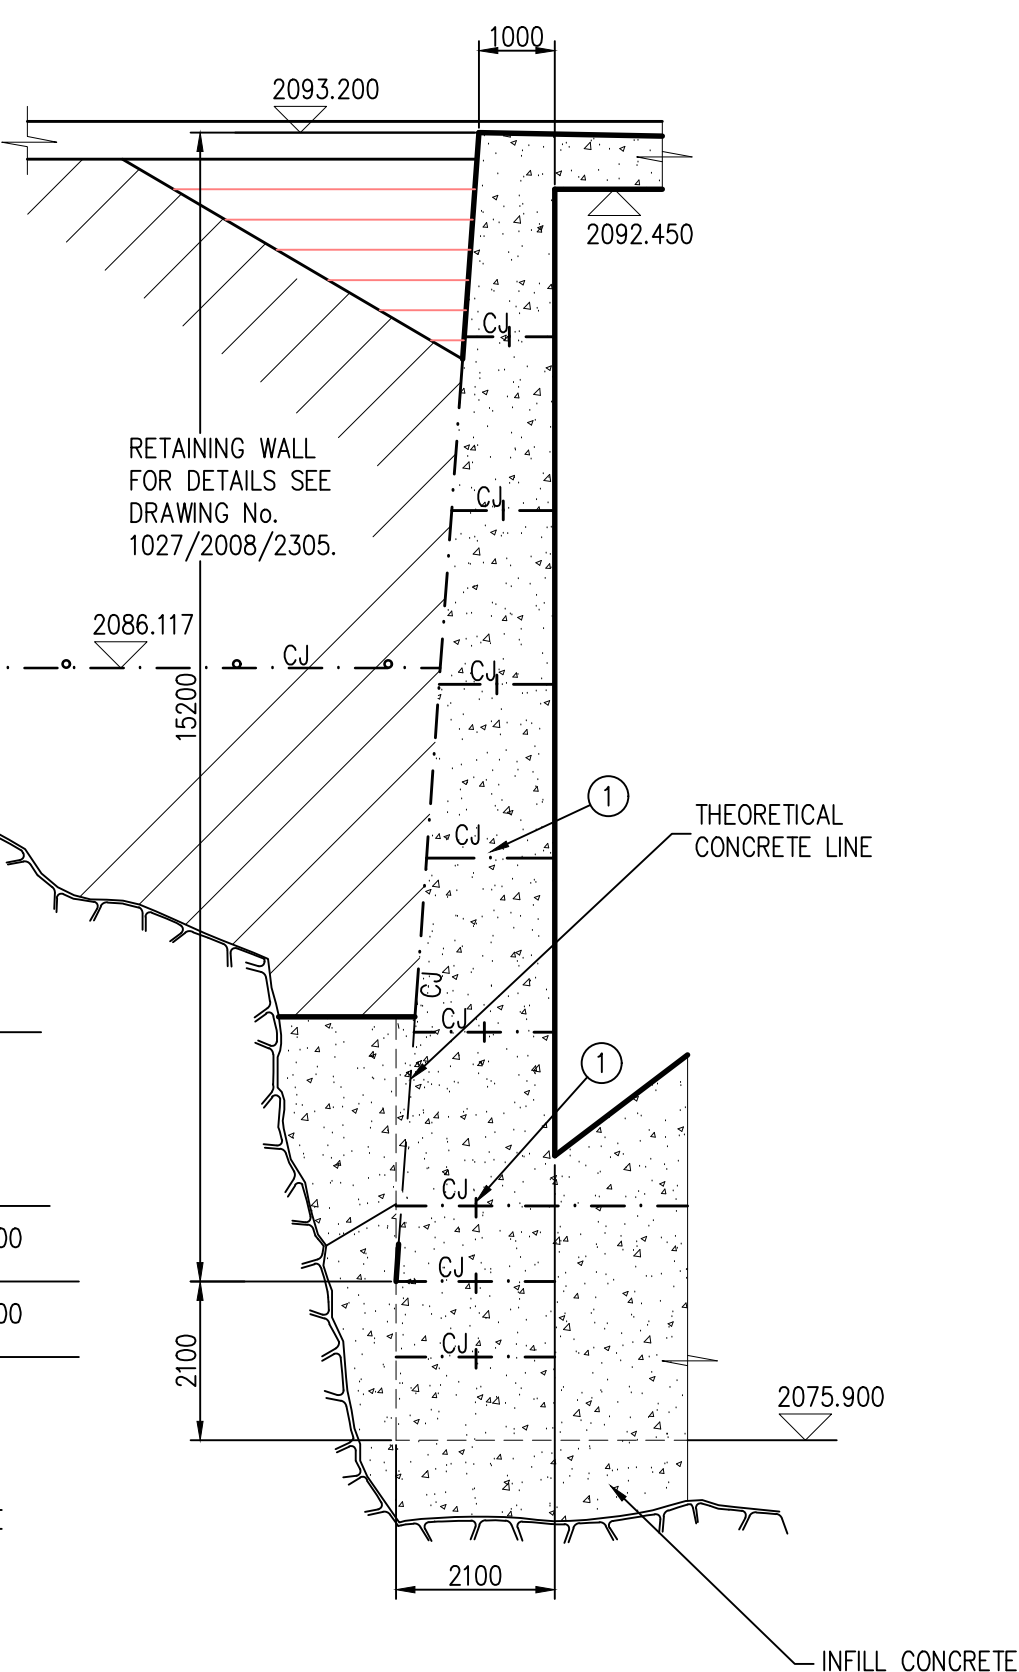

SECTION N
1:100

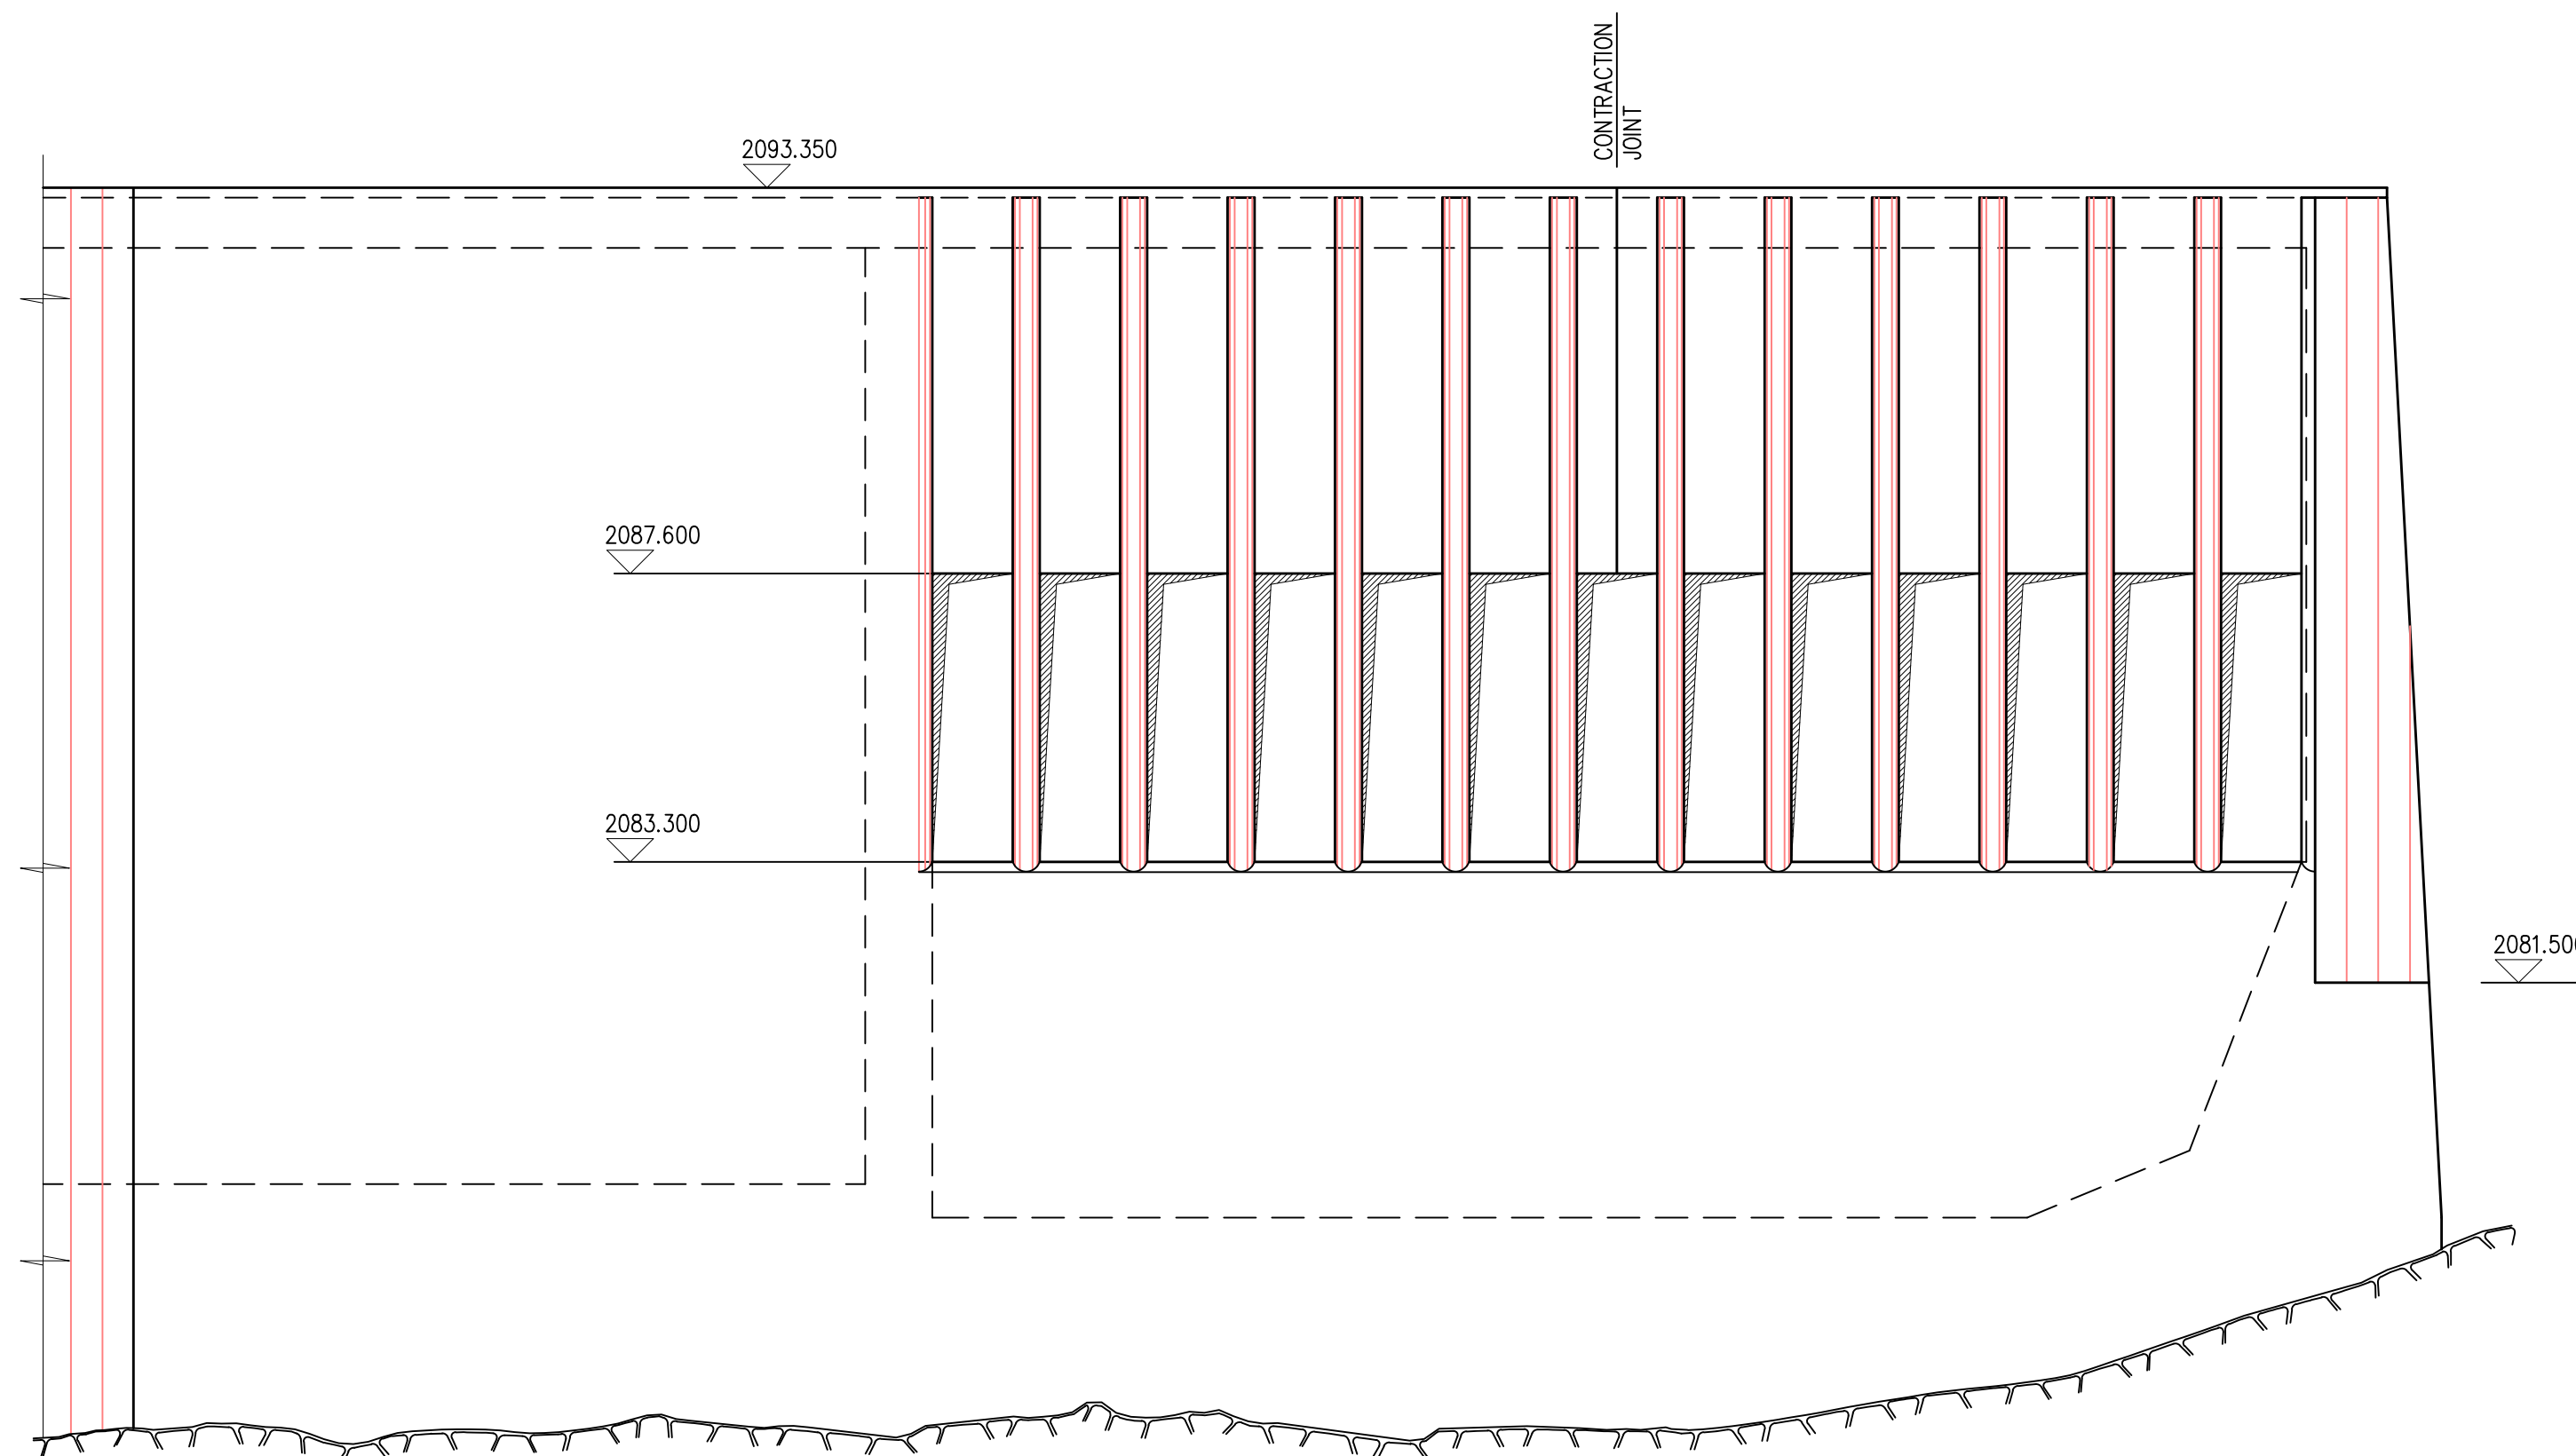


ELEVATION O
1:100

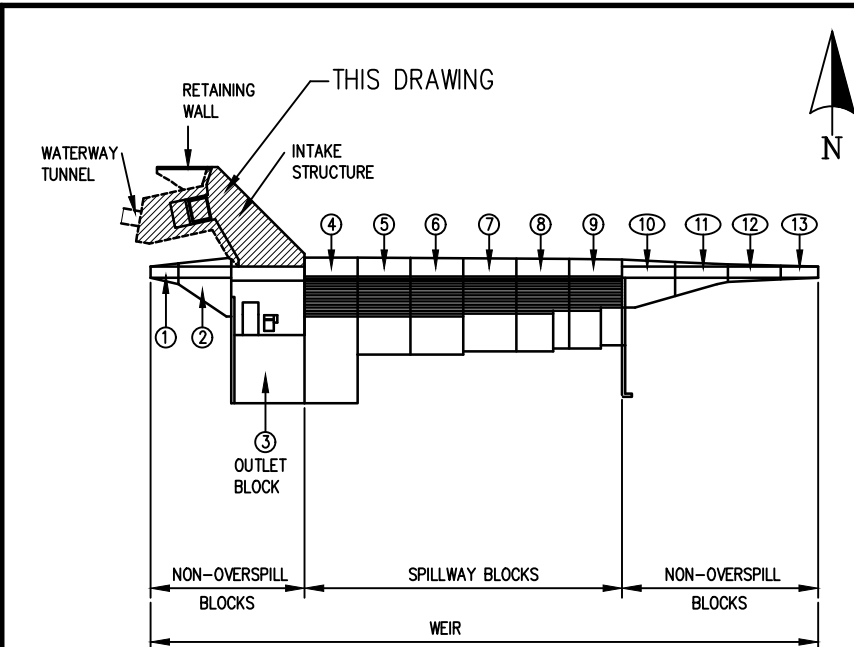

KEY PLAN
N.T.S.

- NOTES.
1. ALL DIMENSIONS ARE IN MILLIMETRES UNLESS SHOWN OTHERWISE.
 2. ALL LEVELS ARE IN METRES ABOVE MEAN SEA LEVEL.
 3. FOR CONCRETE FINISHES AND CLASSES SEE DRG. No. 1027/2008/2300.
 4. ALL FULBORE OUTLETS SHALL BE 100mm NOMINAL DIAMETER 750mm LONG FULBORE COMPLETE WITH GRATE AS SUPPLIED BY: - RHINO VALVES, P.O. Box 6268 DUNSWART 1508 SOUTH AFRICA Tel No. (011) 422 4493
- LEGEND.
- 1 200 x 2mm PVC WATERBAR.
 - 2 250 PVC WATERSTOP.
5. EMBEDDED STEEL ITEM REQUIRED AT OPENINGS - SEE RELATED STEELWORK DRAWINGS.
 6. FOR RELATED MECHANICAL CONTRACTOR'S DRAWING SEE DRG. No. 1027/2008/2302.

RELATED DRAWINGS	
DRG. No.	DESCRIPTION
2300	ELEVATION 2080.000 - PLAN, SECTIONS & DETAIL
2301	ELEVATION 2086.200 - PLAN, SECTION & DETAIL
2302	ELEVATION 2093.500 - PLAN, SECTION & DETAIL
2303	SECTIONS - SHEET 1 OF 2
2204	OUTLET BLOCK - CONCRETE DETAILS - SHEET 1 OF 3
2205	OUTLET BLOCK - CONCRETE DETAILS - SHEET 2 OF 3
2207	OUTLET BLOCK - CONCRETE DETAILS - SHEET 3 OF 3
2305	RETAINING WALL PLAN, SECTION AND ELEVATION
2704-2708	MISCELLANEOUS STEELWORK SHT. 1 OF 5 TO SHT. 5 OF 5

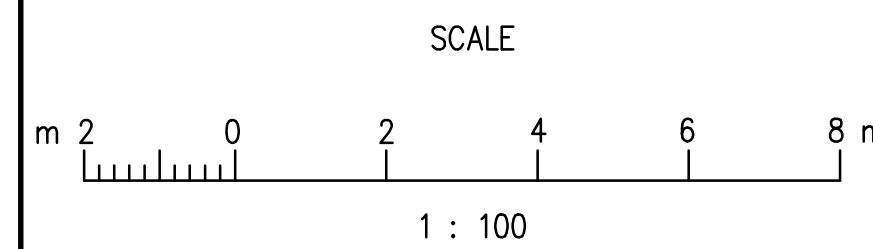

Date	Rev.	Amendment	Dr.	Ch.	App.
04.01	Z	AS BUILT	OGK		
02.99	B	Minor changes	OGK	CJA	EAM
01.99	A	Issued for construction.	OGK	CJA	EAM
11.98	0	Issued for information & comment.	OGK	CJA	EAM

KINGDOM OF LESOTHO
LESOTHO HIGHLANDS DEVELOPMENT AUTHORITY

LESOTHO HIGHLANDS WATER PROJECT
MATSOKU TUNNEL AND WEIR

INTAKE SECTIONS
SHEET 2 OF 2

MATSOKU DIVERSION PARTNERSHIP

Lesson FMA Joint Venture
 Lesotho Consulting Engineers
 FM Associates

Consult 4
 Nihum Shand
 V.K.E. Consulting Engineers
 Kewee Shany
 Steffen Robertson & Kirsten (Cons. Eng.)
 Knight Piesold

Date	Drawing no.	Rev.
JUL. 98	1027/2008/ 2304	Z

Project Manager